




LEGEND	
	ASBUILT CONTOUR (MAJOR)
	ASBUILT CONTOUR (MINOR)
	ASBUILT BOUNDARY
	NOMINATED BUILDING PLATFORM
	BUILDING RESTRICTION ZONE

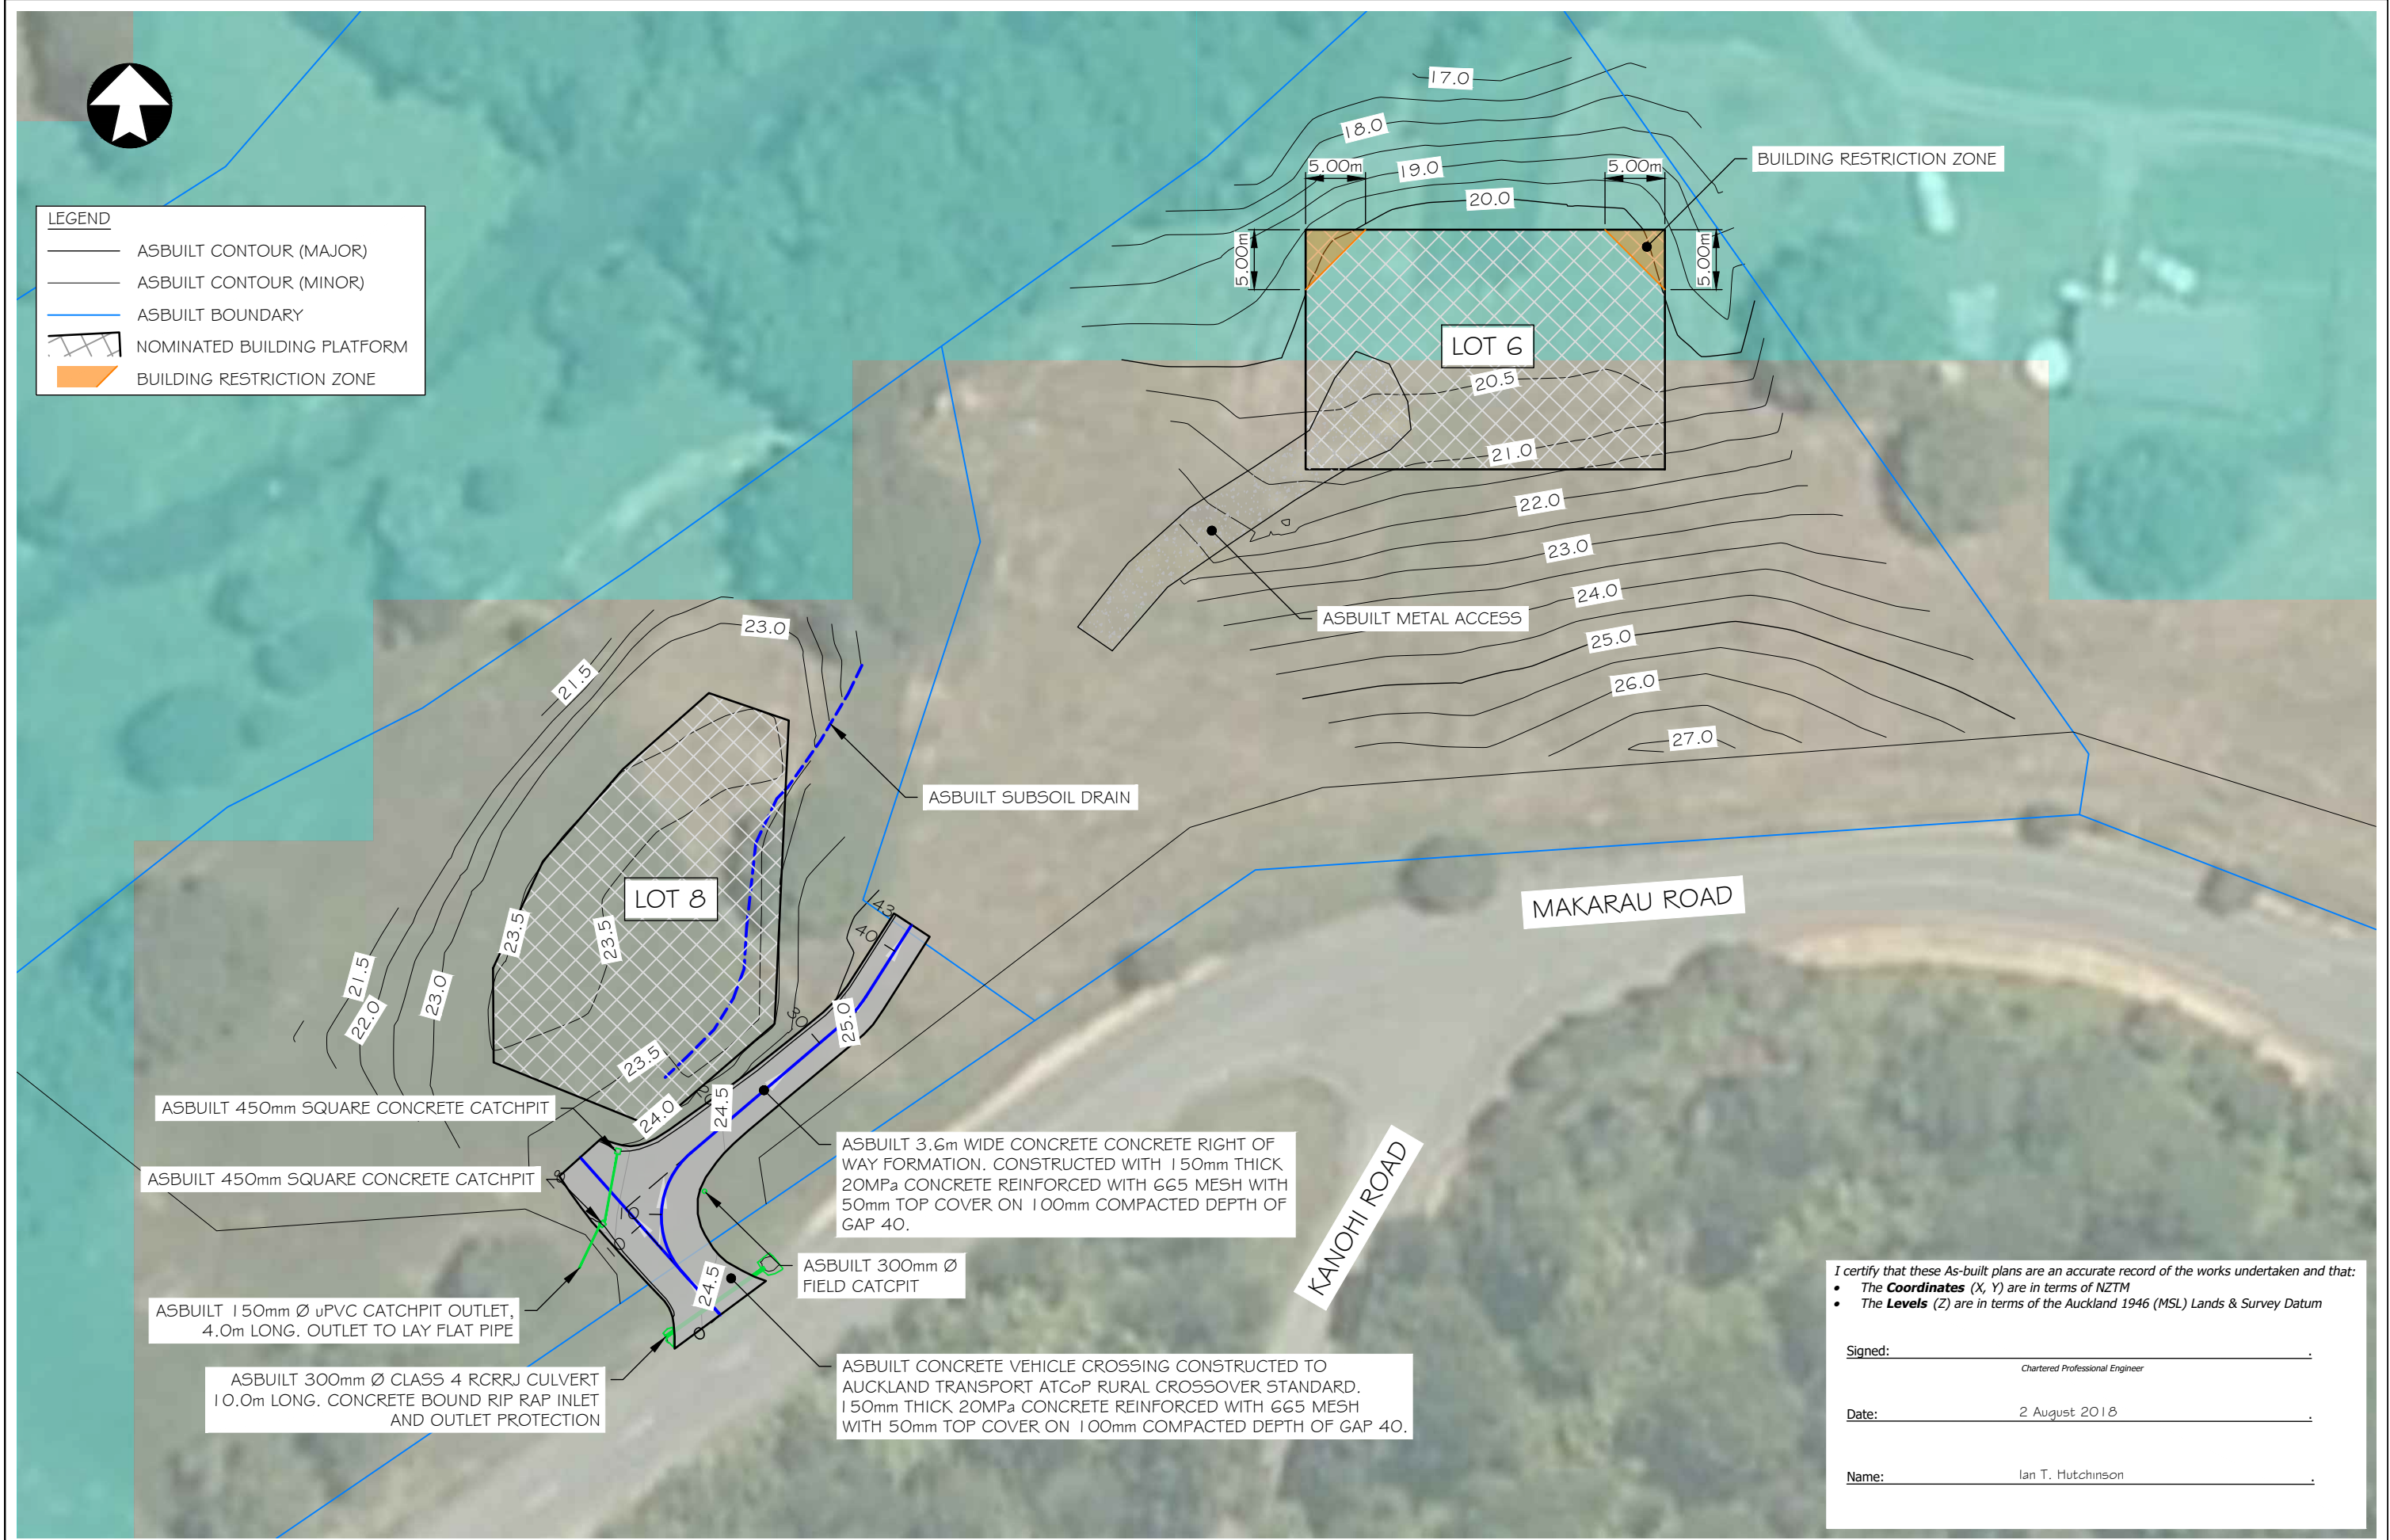

I certify that these As-built plans are an accurate record of the works undertaken and that:

- The **Coordinates** (X, Y) are in terms of NZTM
- The **Levels** (Z) are in terms of the Auckland 1946 (MSL) Lands & Survey Datum

Signed: _____
Chartered Professional Engineer

Date: 2 August 2018

Name: Ian T. Hutchinson

No.	Revision	Drawn	Chk.	Appd.	Date
A	REVISED BUILDING PLATFORM EXTENTS	MS	PF	IH	NOV 2018

Hutchinson
CONSULTING ENGINEERS

PO Box 150, Orewa 0946
 154 Centreway Road, Orewa 0931
 Ph: 09 426 5702 www.hc.co.nz

Design	M. SYMONS	JUL 2018
Drawn	M. SYMONS	JUL 2018
Checked	P. FARLEY	JUL 2018
Approved	I. HUTCHINSON	JUL 2018
Scale	1:500 @ A3	
Scale vert. exag.		

Project	SH16 LIMITED PROPOSED SUBDIVISION AT MAKARAU ROAD, MAKARAU ASBUILTS
---------	---

Title	ASBUILT SITE PLAN
Job No.	A3-20255

Sheet No.	AB-002
-----------	--------